


Date: _____
 Time: _____
 Plan No.: _____
 Attest: _____ Register


RESERVED FOR REGISTRY USE

NOTE:
 ALL MEASUREMENTS ARE WITHIN 1/2"±.
 MEASUREMENTS ARE TO EXISTING INTERIOR
 FINISHED CONDITIONS.
 MEASUREMENTS BY ETHAN MCMORROW DESIGNS
 DATED: 07/11/2019

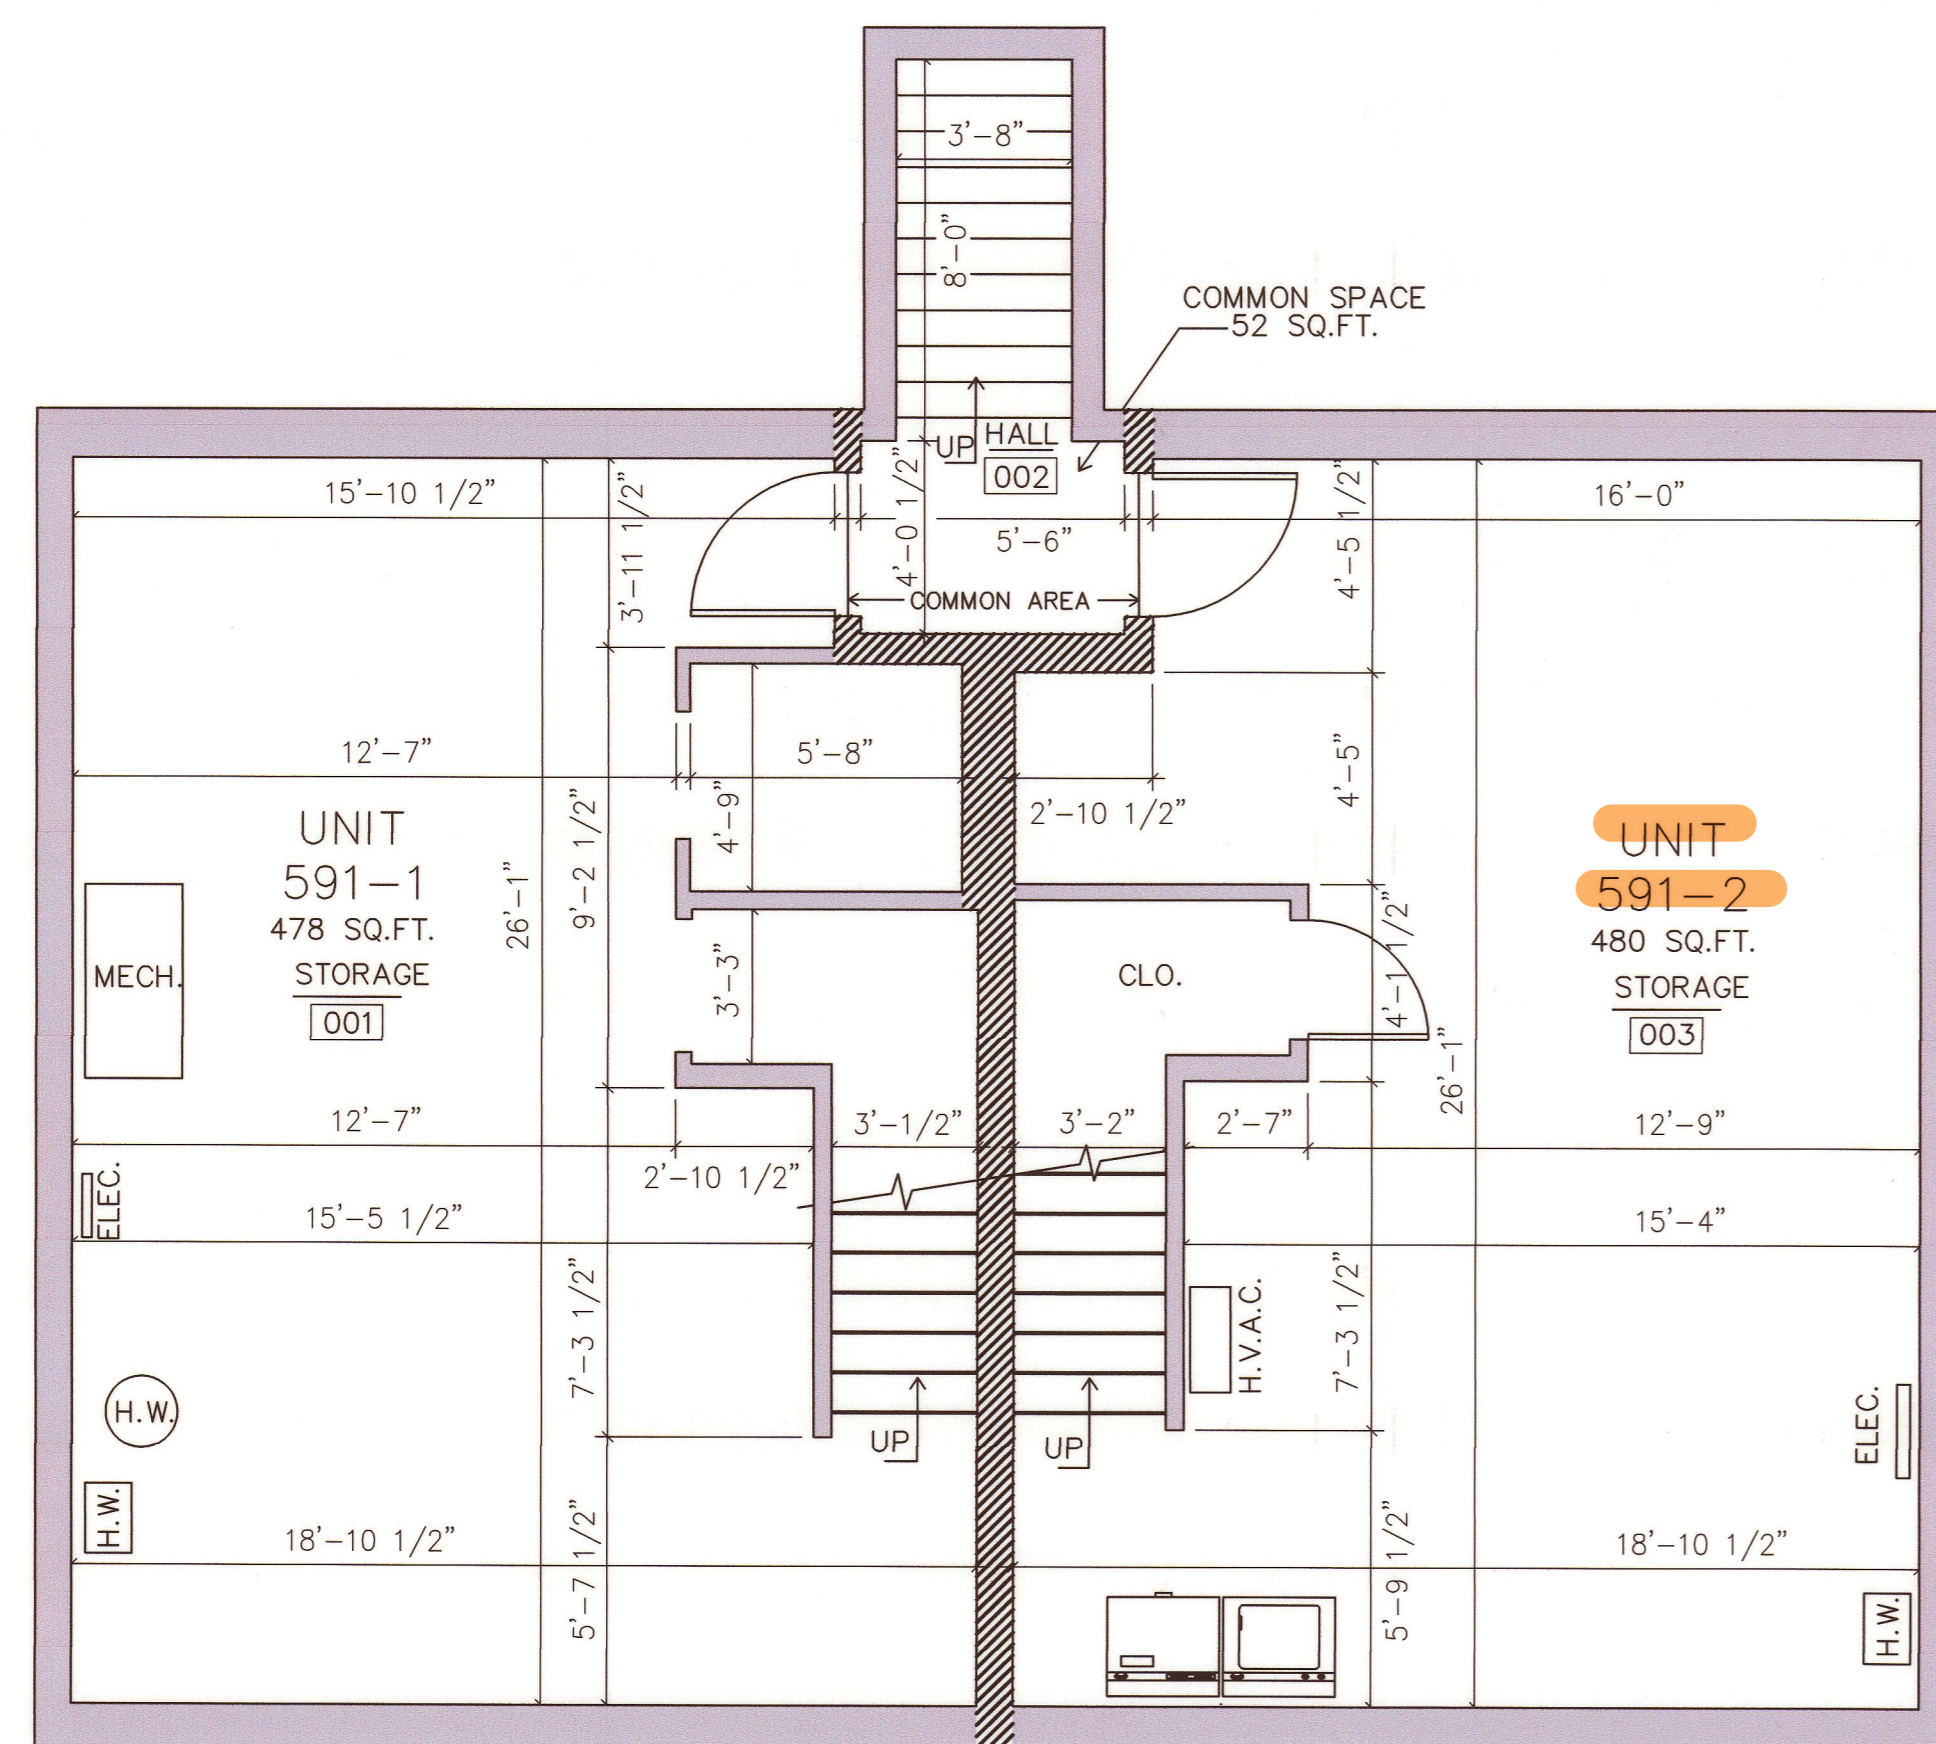

EXISTING BASEMENT PLAN FOR UNITS 591-1 & 591-2
 SCALE: 1/4"=1'-0"

BOUNDARY WALL
 BETWEEN COMMON AREA,
 UNIT A & UNIT B

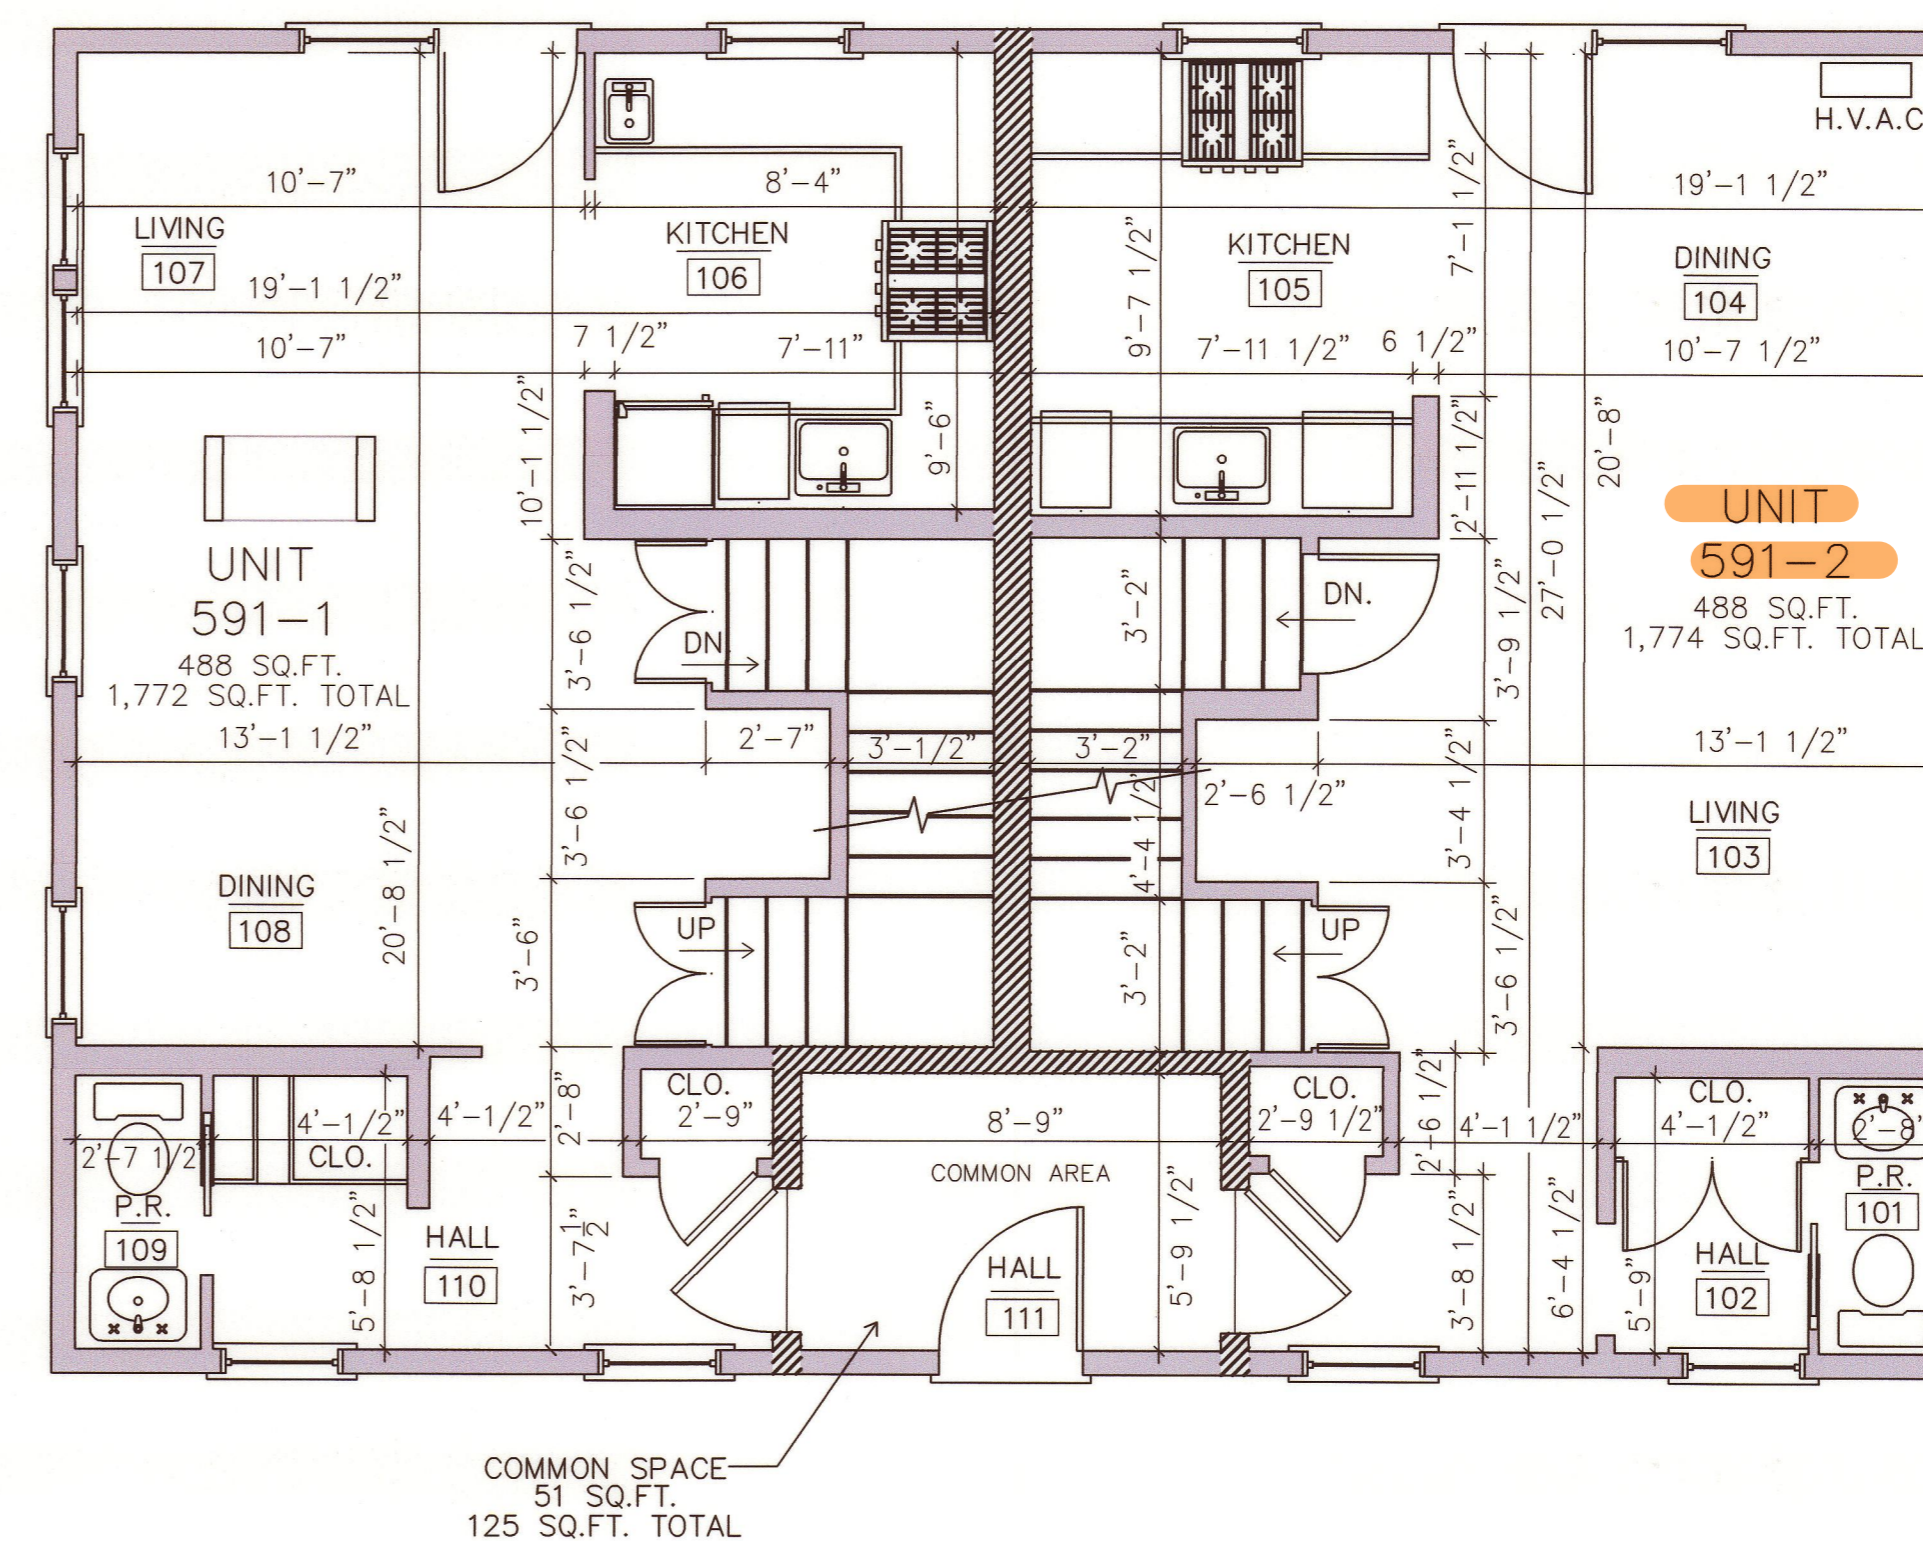


EXISTING FIRST FLOOR PLAN FOR UNITS 591-1 & 591-2
 SCALE: 1/4"=1'-0"

OWNER INFORMATION

ROBERT T. HAY
 KATHLEEN A. S. HAY
 Cert. U42074
 UNIT No. 591-1
 CONDOMINIUM PLAN No. 02-19 & 2007-78
 L.C.C. 16514-36, LOT 591
 ASSESSOR'S MAP 68, PARCEL 470
 #4 WITHERSPOON DRIVE

OWNER INFORMATION

KATHLEEN A.S. HAY
 ROBERT T. HAY
 Cert. U42268
 UNIT No. 591-2
 CONDOMINIUM PLAN No. 02-19 & 2007-78
 L.C.C. 16514-36, LOT 591
 ASSESSOR'S MAP 68, PARCEL 470
 #4 WITHERSPOON DRIVE

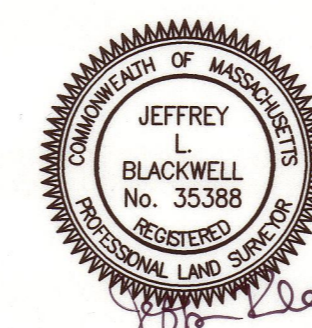

I HEREBY CERTIFY THAT THIS PLAN
 FULLY AND ACCURATELY DEPICTS THE
 LOCATION AND DIMENSIONS OF THE
 BUILDING(S) AS-BUILT.

I HEREBY CERTIFY THAT THIS PLAN HAS BEEN
 PREPARED IN ACCORDANCE WITH THE RULES
 AND REGULATIONS OF THE REGISTER OF DEEDS
 OF THE COMMONWEALTH OF MASSACHUSETTS.


PROFESSIONAL LAND SURVEYOR 8-28-2019
 DATE

Master Deed Floor Plan
 WITHERSPOON CONDOMINIUM I
 Condominium

#4 WITHERSPOON DRIVE
 Scale: 1"= 4' August 28, 2019

BLACKWELL & ASSOCIATES, Inc.
 Professional Land Surveyors
 20 TEASDALE CIRCLE
 NANTUCKET, MASS. 02554
 (508) 228-9026

GRAPHIC SCALE

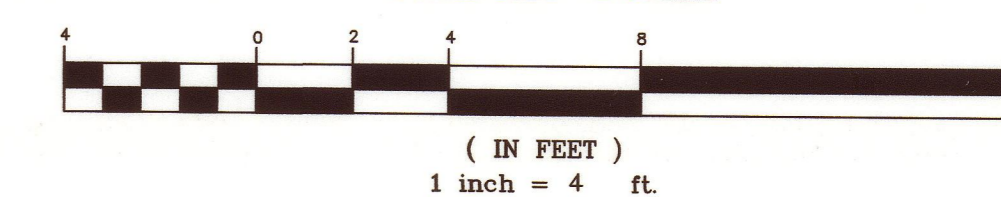

Date: _____

Time: _____


Plan No.: _____

Attest: _____ Register

RESERVED FOR REGISTRY USE


NOTE:

ALL MEASUREMENTS ARE WITHIN 1/2"±.
MEASUREMENTS ARE TO EXISTING INTERIOR
FINISHED CONDITIONS.
MEASUREMENTS BY ETHAN McMORROW DESIGNS
DATED: 07/11/2019

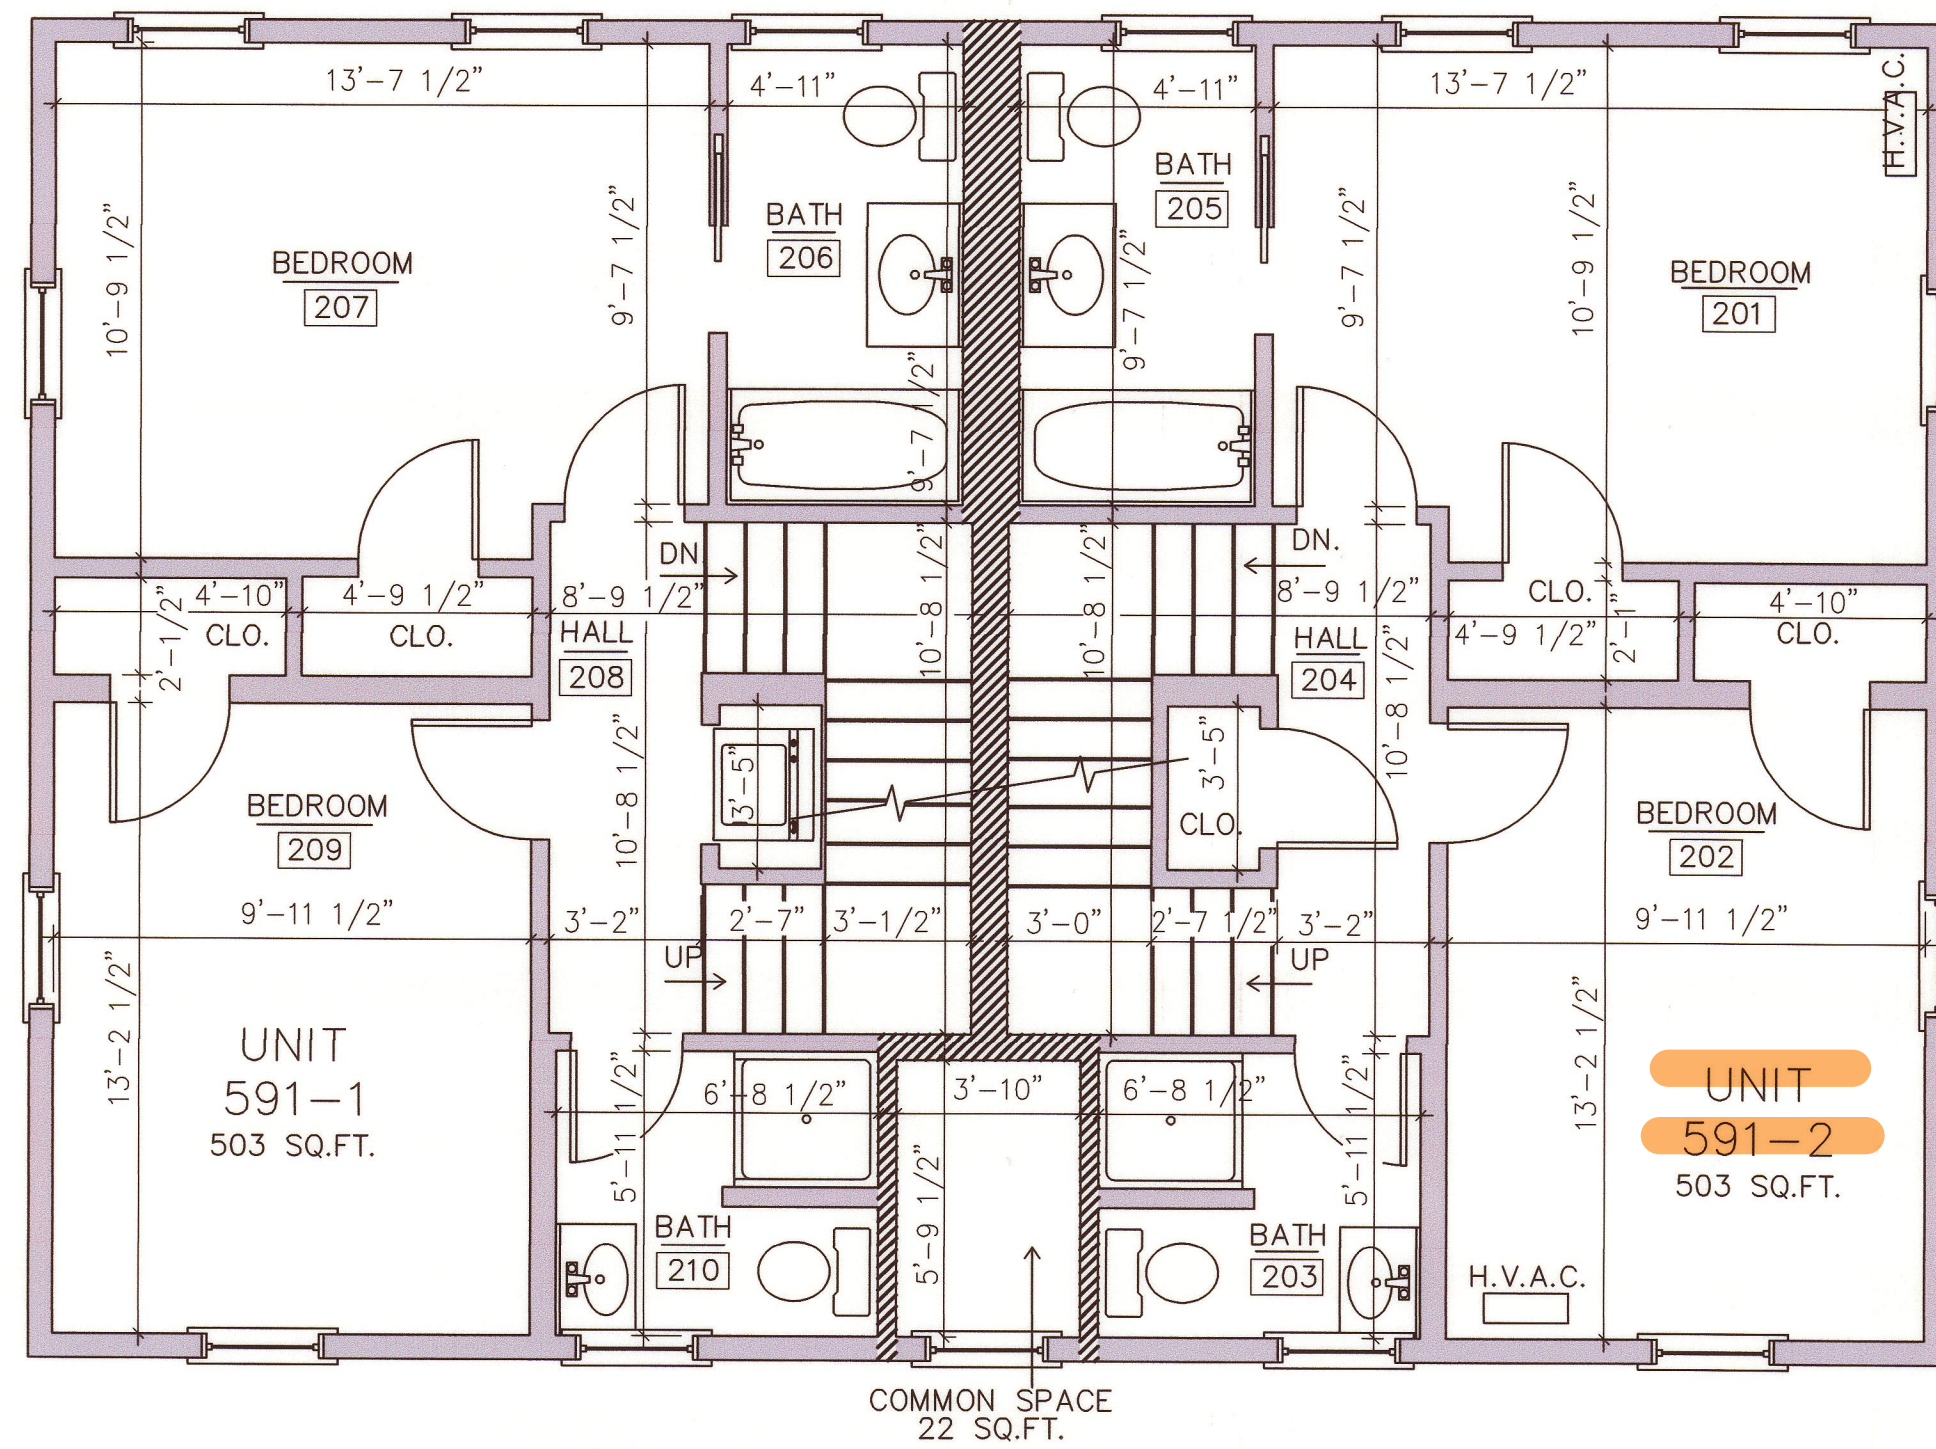

EXISTING SECOND FLOOR PLAN FOR UNITS 591-1 & 591-2
SCALE: 1/4"=1'-0"

BOUNDARY WALL
BETWEEN COMMON AREA,
UNIT A & UNIT B

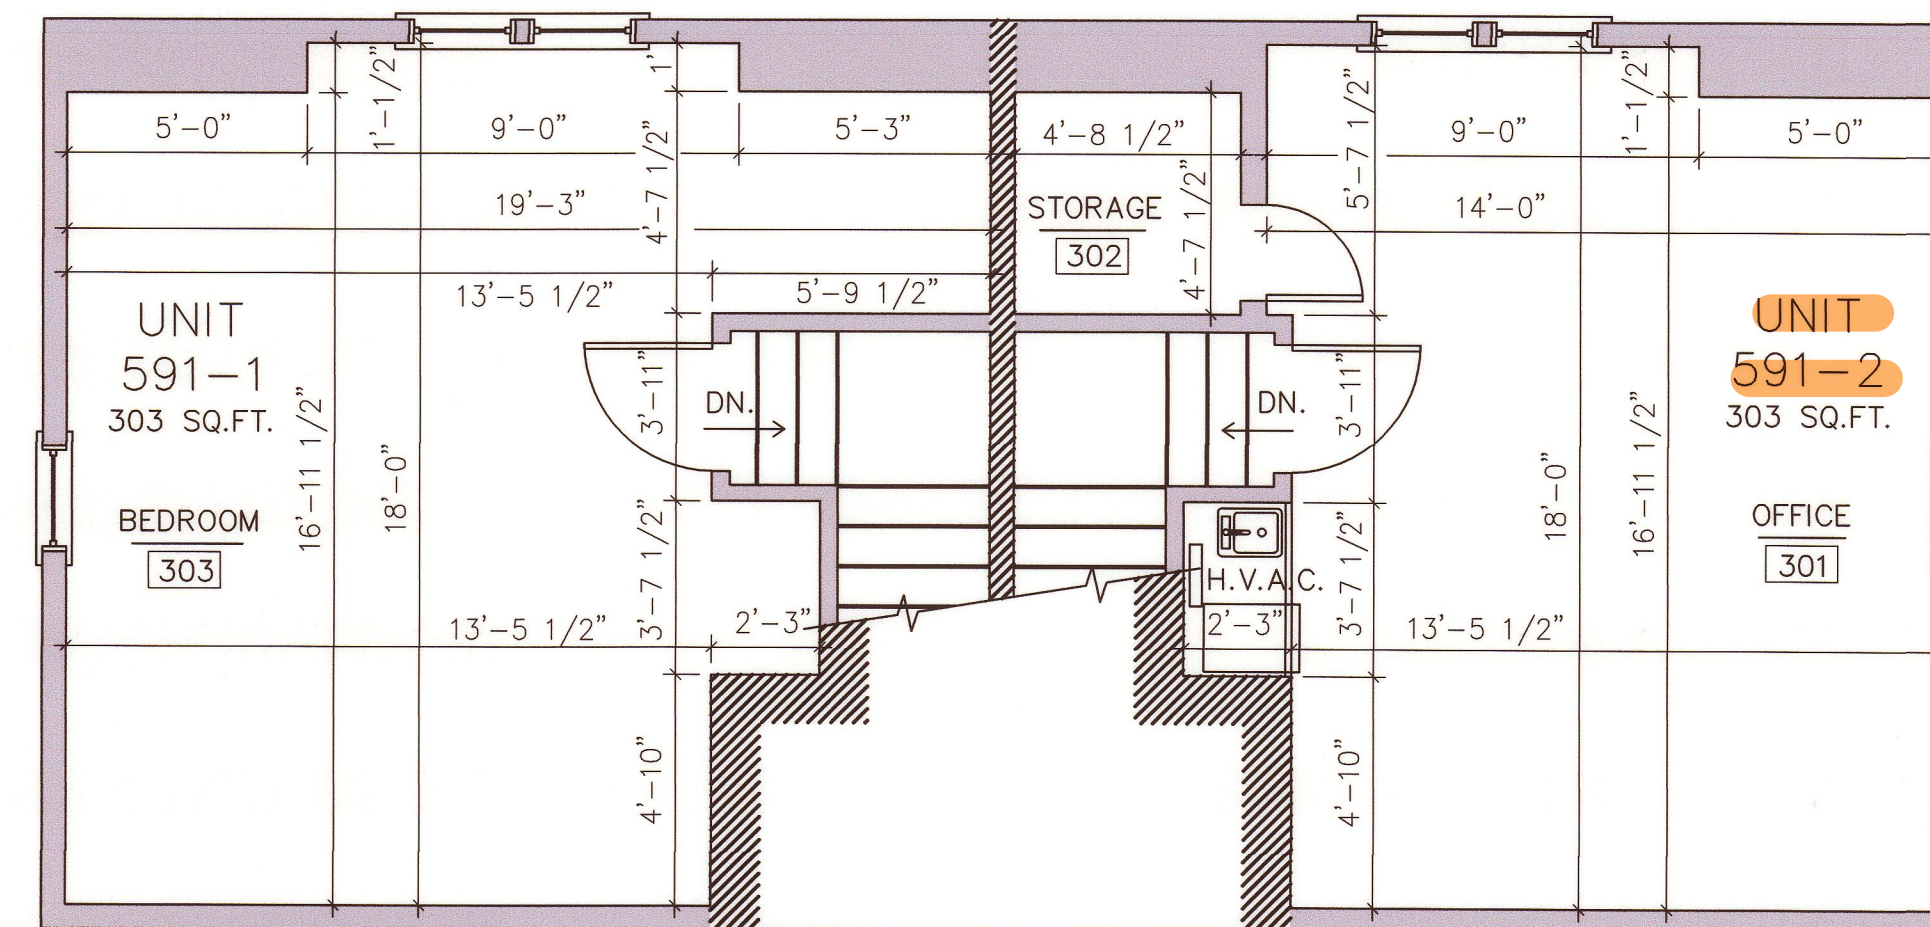


EXISTING THIRD FLOOR PLAN FOR UNITS 591-1 & 591-2
SCALE: 1/4"=1'-0"

Master Deed Floor Plan
WITHERSPOON CONDOMINIUM I
Condominium

#4 WITHERSPOON DRIVE
Scale: 1"= 4' August 28, 2019

BLACKWELL & ASSOCIATES, Inc.
Professional Land Surveyors
20 TEASDALE CIRCLE
NANTUCKET, MASS. 02554
(508) 228-9026

GRAPHIC SCALE

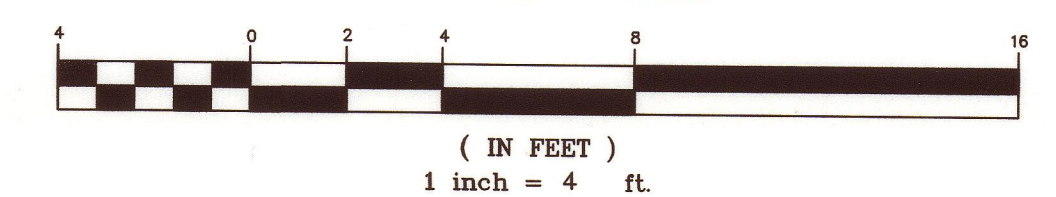

OWNER INFORMATION

ROBERT T. HAY
KATHLEEN A. S. HAY
Cert. U42074
UNIT No. 591-1
CONDOMINIUM PLAN No. 02-19 & 2007-78
L.C.C. 16514-36, LOT 591
ASSESSOR'S MAP 68, PARCEL 470
#4 WITHERSPOON DRIVE

OWNER INFORMATION

KATHLEEN A.S. HAY
ROBERT T. HAY
Cert. U42268
UNIT No. 591-2
CONDOMINIUM PLAN No. 02-19 & 2007-78
L.C.C. 16514-36, LOT 591
ASSESSOR'S MAP 68, PARCEL 470
#4 WITHERSPOON DRIVE



I HEREBY CERTIFY THAT THIS PLAN
FULLY AND ACCURATELY DEPICTS THE
LOCATION AND DIMENSIONS OF THE
BUILDING(S) AS-BUILT.

I HEREBY CERTIFY THAT THIS PLAN HAS BEEN
PREPARED IN ACCORDANCE WITH THE RULES
AND REGULATIONS OF THE REGISTER OF DEEDS
OF THE COMMONWEALTH OF MASSACHUSETTS.

Jeffrey L. Blackwell
PROFESSIONAL LAND SURVEYOR
8-28-2019
DATE