


RECORDED AND ENTERED WITHIN OF
NANTUCKET COUNTY DEEDS BOOK OF
PLANS NO. 31-6 PAGE
ATTEST REGISTER

Sandra M. Chastinet
August 8, 1998 8:55 am

Shevalier
Associates
Architects
Raynham
Massachusetts

JOB NO.

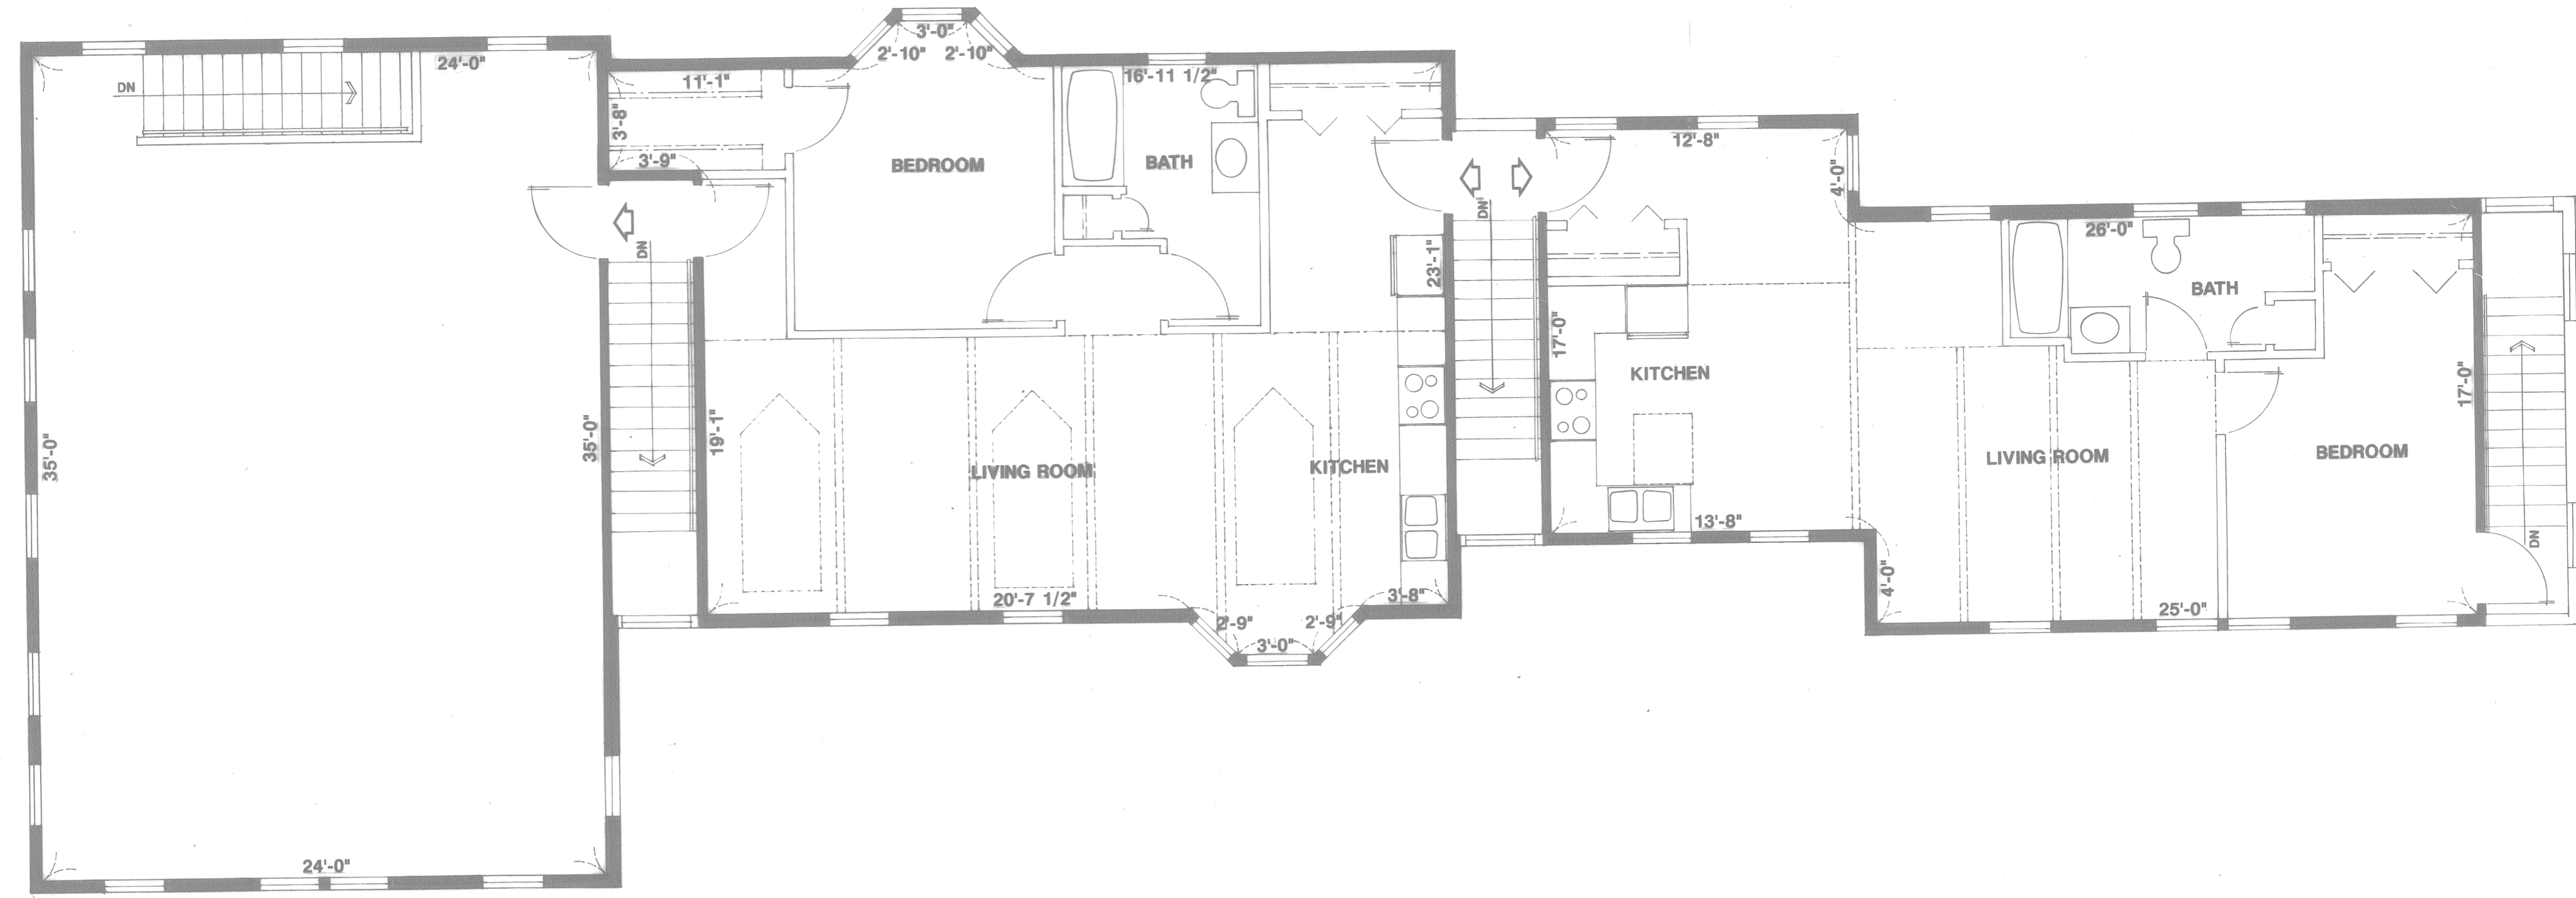

UNIT 2.4
EL SF = 24.20'
EL UC = 32.30'
AREA = 1844.73 S.F.
UNDERSIDE OF RIDGE EL = 41.60'

UNIT 2.5
EL SF = 24.20'
EL UC = 32.30'
AREA = 768.44 S.F.
UNDERSIDE OF RIDGE EL = 41.60'

UNIT 2.6
EL SF = 24.20'
EL UC = 32.30'
AREA = 1658.17 S.F.
UNDERSIDE OF RIDGE EL = 41.60'

SECOND FLOOR PLAN

BUILDING NO. 2

**NANTUCKET COMMONS
CONDOMINIUM**
NANTUCKET, MA.

BUILDING #2
AS-BUILT SECOND
FLOOR PLAN

AB-3

"I HEREBY CERTIFY THAT THIS PLAN FULLY AND ACCURATELY
DEPICTS THE LAYOUT, LOCATION, UNIT NUMBER AND DIMENSIONS
OF THE UNITS AS BUILT."

"I HEREBY CERTIFY THAT THIS PLAN CONFORMS WITH THE
RULES AND REGULATIONS OF THE REGISTERS OF DEEDS OF
THE COMMONWEALTH OF MASSACHUSETTS."
SIGNED *[Signature]* DATE 8/4/98

- LEGEND**
- EL CS = ELEVATION OF TOP SURFACE OF CONCRETE SLAB
 - EL SF = ELEVATION OF TOP SURFACE OF SUBFLOOR
 - EL UC = ELEVATION TO UNDERSIDE OF CEILING
 - [Symbol] = DIMENSIONS FROM FINISH TO FINISH
 - [Symbol] = MAIN ENTRY TO UNIT
 - [Symbol] = LIMITS OF UNIT
 - [Symbol] = COMMON SPACE OR INTERIOR WALLS OF UNITS

