Doc: PLAN 05/05/2008 02:42 PM

NANTUCKET REGISTRY OF DEEDS
DATE: 05.05.2008
TIME: 2:42 PM
BOOK: 2008
PAGE: 32
Jennifer Ferreira
Recorder

SHEET 1 OF 1

N

LOT 642 – LCP # 16514-40

ASSESSORS MAP 68 PARCEL 753

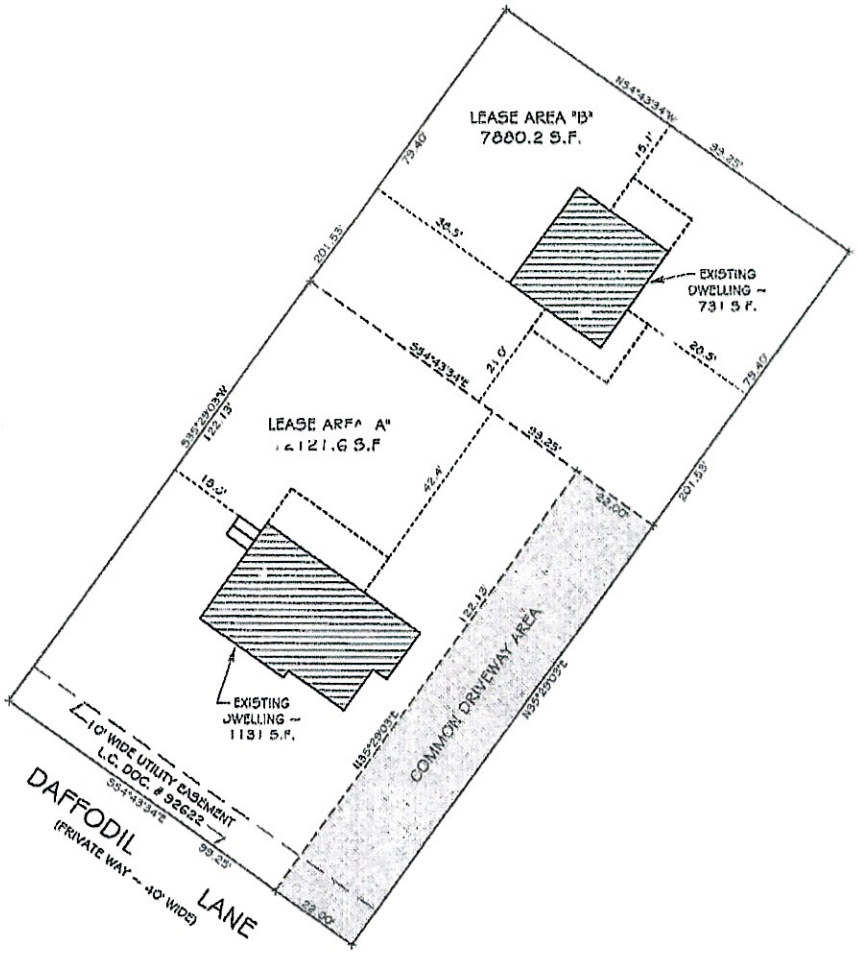

I HEREBY CERTIFY THAT THIS PLAN HAS BEEN PREPARED IN ACCORDANCE WITH THE RULES AND REGULATIONS OF THE REGISTER OF DEEDS OF THE COMMONWEALTH OF MASSACHUSETTS.

5-10-08
DATE

REGISTERED LAND SURVEYOR

13 DAFFODIL LANE COOPERATIVE INC.
PLAN OF LAND
IN
NANTUCKET, MA
PREPARED FOR
TYRONE RYBACK

SCALE:	DRAWN BY:
1" = 20'	TMW
JOB NUMBER: 07-048	DATE: 12-18-2007
SHEET NUMBER: COOP-1	

WELLER & ASSOCIATES
1645 FALMOUTH RD., SUITE 1C ~ P.O. BOX 417 CENTERVILLE, MA 02632
2 WINDY WAY, #232 NANTUCKET, MA 02554
TEL. (508) 775-0795 ~ FAX (508) 775-0714
EMAIL: tmweller@comcast.net
PROFESSIONAL ENGINEERS & LAND SURVEYORS